



HISTORIC PRESERVATION PERMIT

An Historic Preservation Permit for work described below has been issued under the Zoning Ordinance of the City of Tulsa (Section 70.070) to **Johnny Dale Reeves**, for the address of **1704 S Yorktown Ave**, Tulsa, Oklahoma, located in the **Yorktown Historic Preservation Overlay District**. This proposal has been approved by the Tulsa Preservation Commission.

Any changes to the Approved Proposal require further review and approval by the Tulsa Preservation Commission prior to work being done. Unapproved changes to the Approved Proposal are a violation of the Zoning Ordinance and may result in revocation of a Building Permit and/or code enforcement.

This Historic Preservation Permit is not a Building Permit for residential or commercial zoning. A copy of this permit and approved project plans should be provided to the City of Tulsa Permit Center for the completion of the process to obtain a Building Permit, if applicable.

APPROVED PROPOSAL


1. Relocation of garage

A handwritten signature in cursive script that reads "Felicity Good".

Felicity Good
Historic Preservation Officer (interim), City of Tulsa

Date issued: November 9, 2024
Expiration: November 10, 2026
Number: HP-0575-2024

Change location of Garage from 5ft to 8.5ft to allow for sanitary sewer easement.

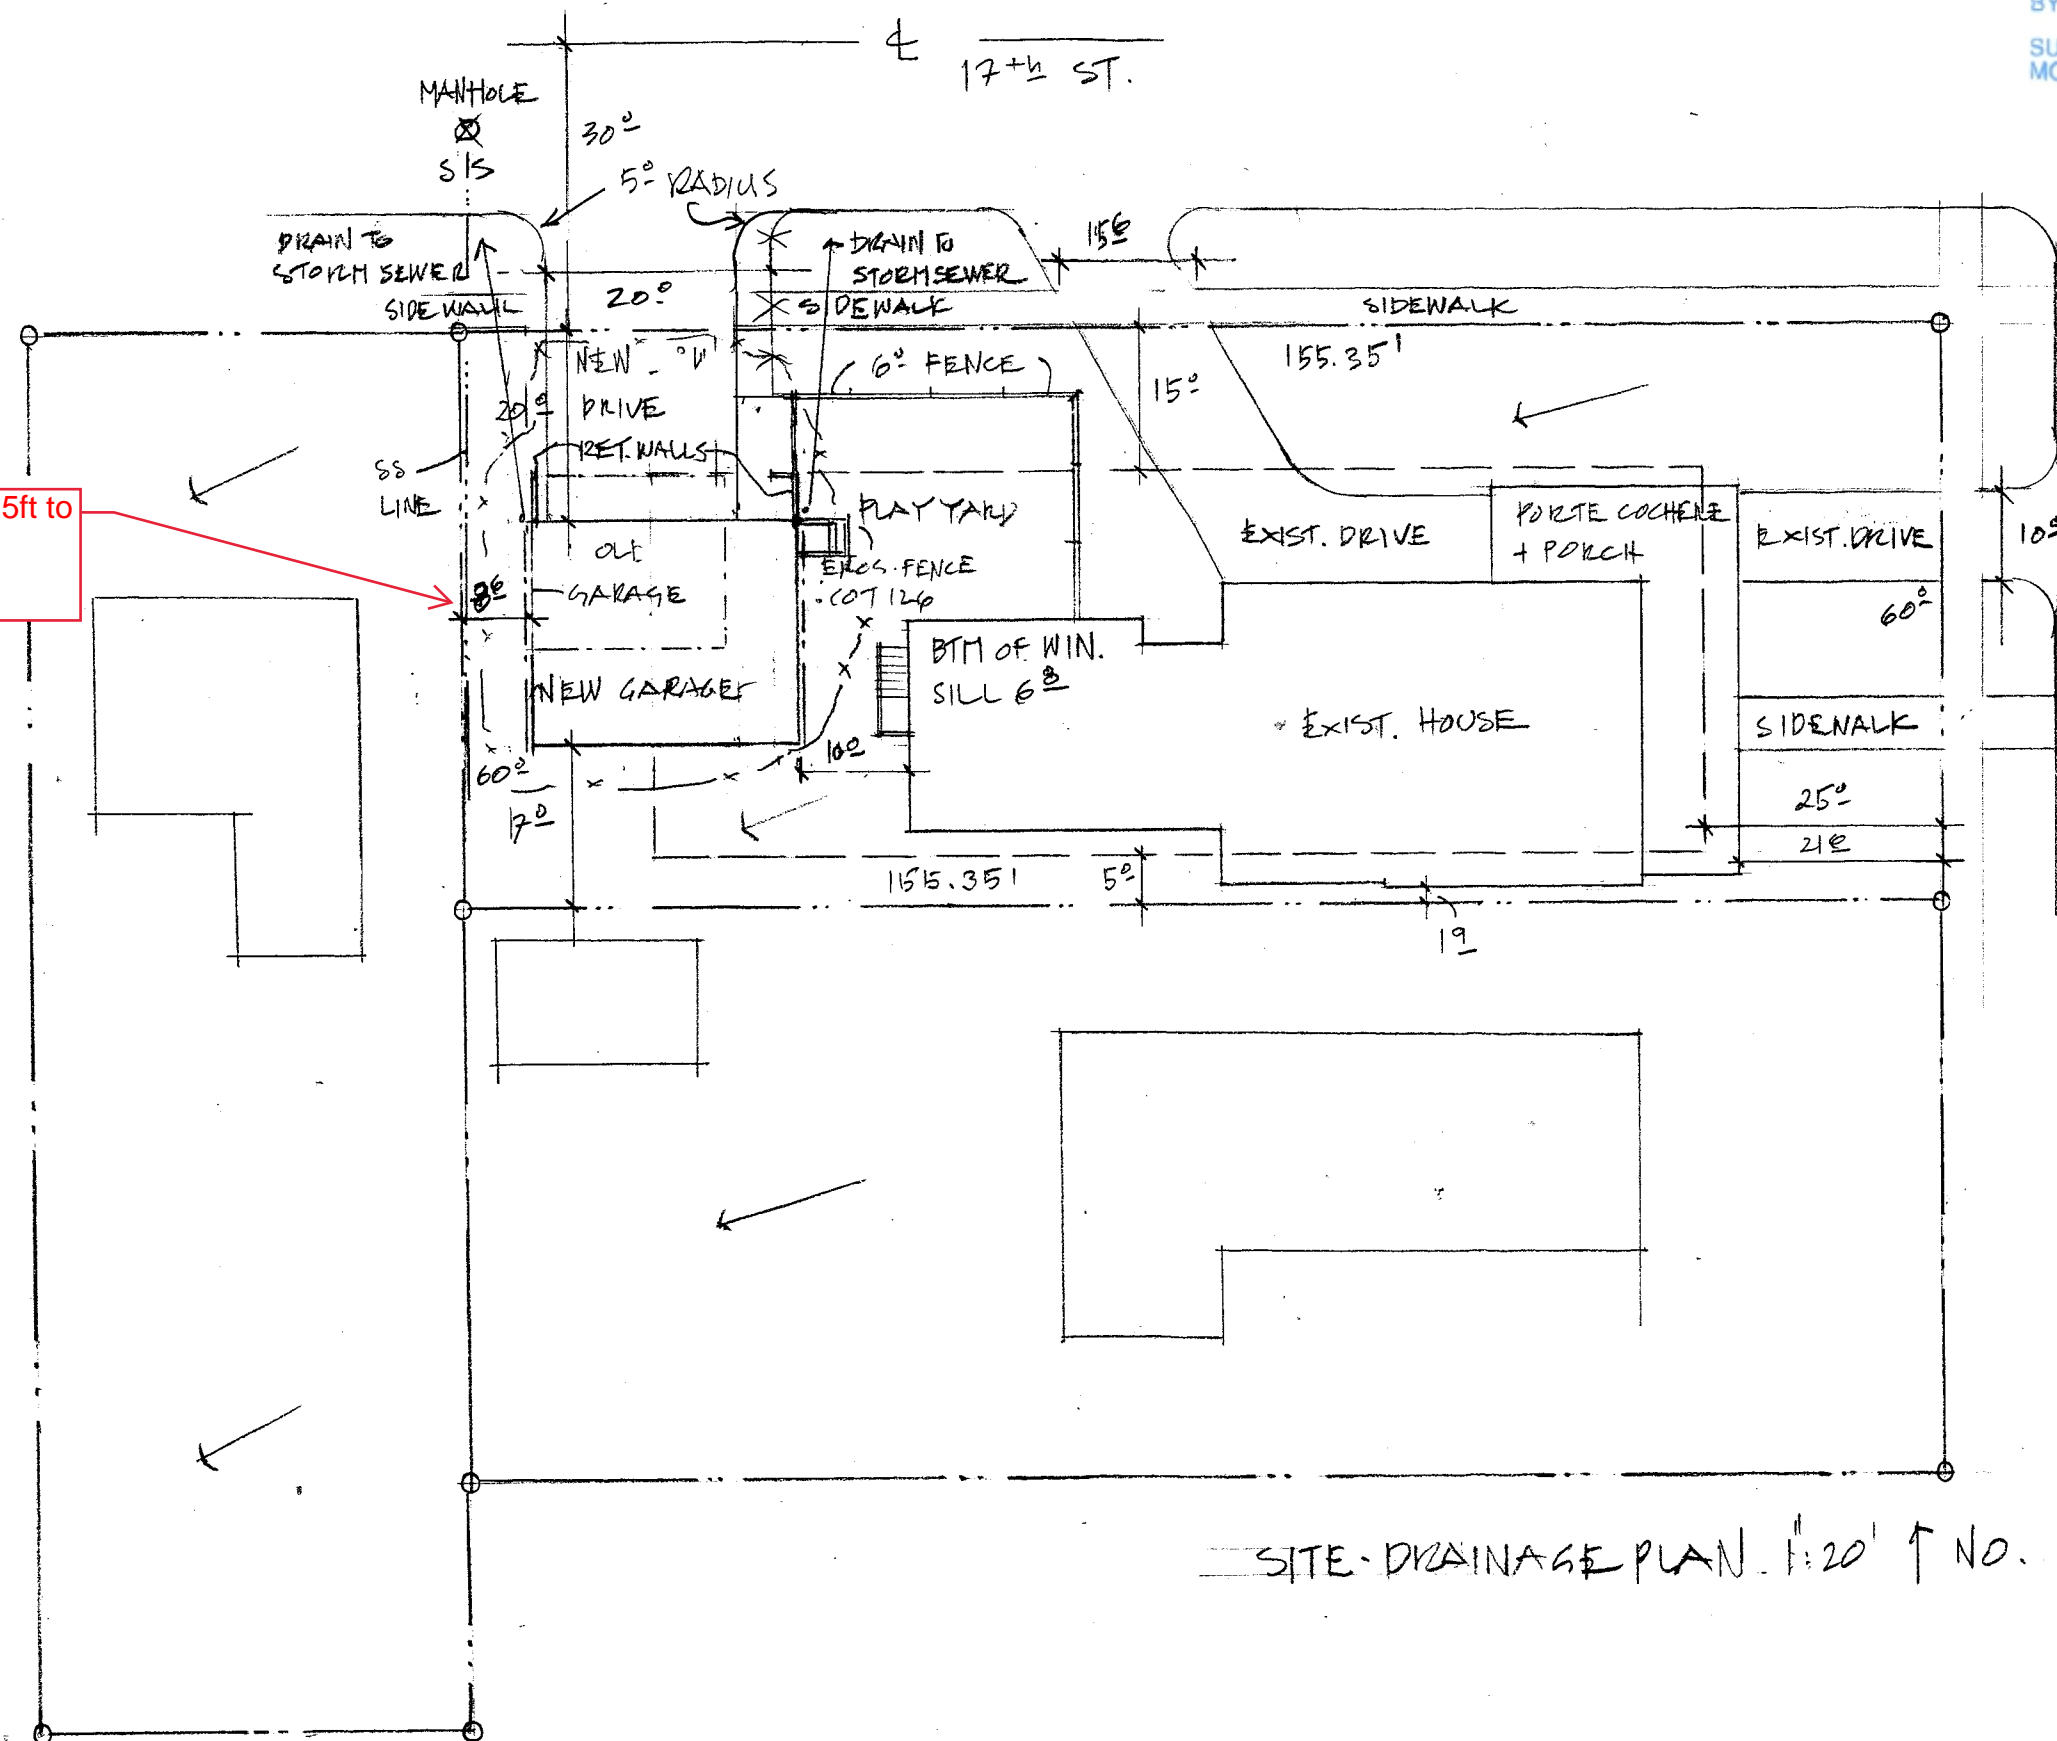

3.2024
~~1.2024~~
 REEVES ~~11.2023~~
 1704 SO. YORKTOWN
 TULSA OKLA ~~5.2023~~

SITE DRAINAGE PLAN 1"=20' ↑ NO.